





HERITAGE LOG HOMES
 ONE HERITAGE PLACE KODAK, TN 37764
 1-800-456-HOME
 WWW.HERITAGELOG.COM

NAME	HELLAND
LOG STYLE	10414
DRAWING SCALE	AS NOTED
PLAN NAME	1ST FLOOR PLAN
ROOM TYPE	SQUARE
FOUNDATION	BASEMENT
SUBS PERSON	JOHN GICK

CHECKED BY	7
DATE	2/1/2007
DRAWN BY	D.S.
REVISIONS	

DRAWING NUMBER
4 OF 7

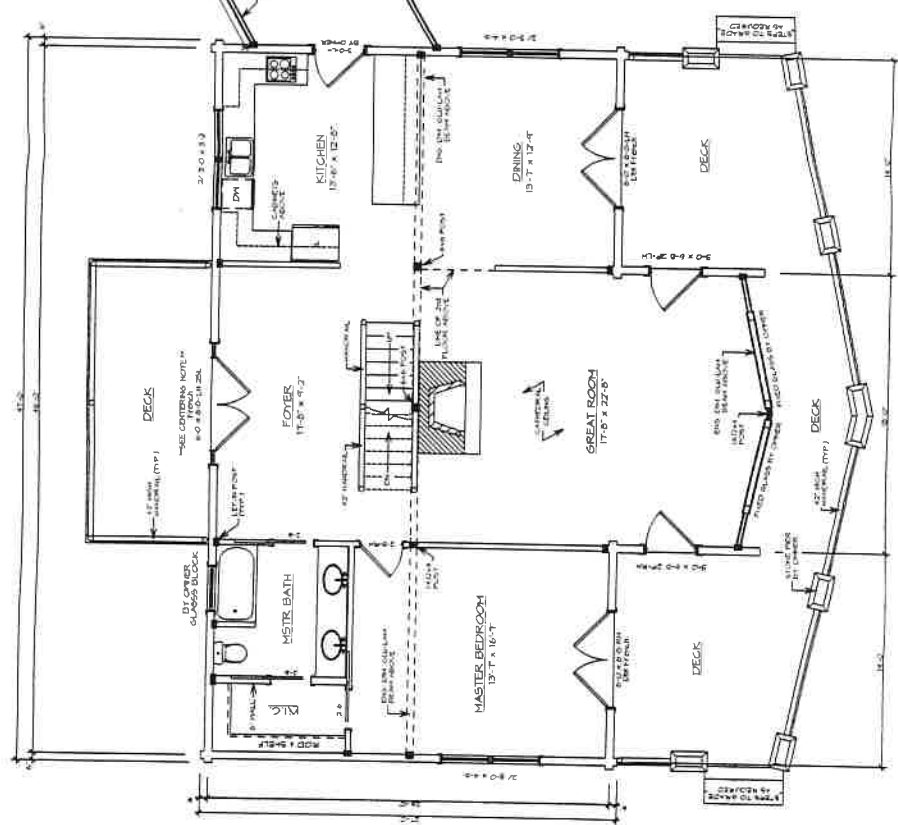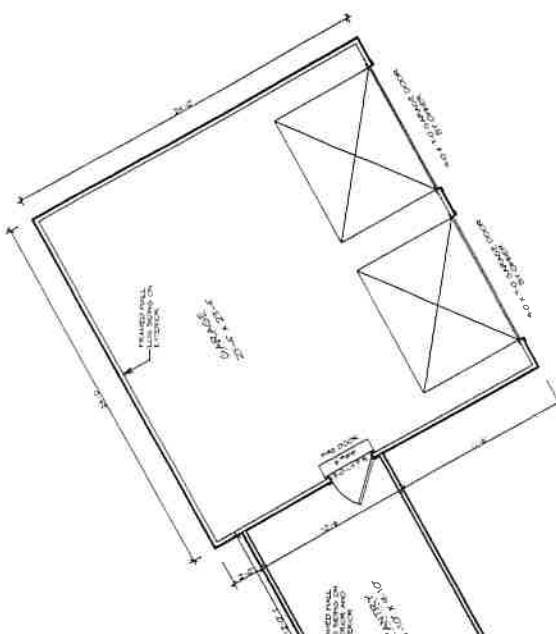

CONTENTS NOTE: FOR OPENING TO BE MADE IN THE PORCH, RECONSTRUCTION HAS BEEN MADE TO MAINTAIN STANDARD LOG LOGISTICS. OPENINGS WILL NEED TO BE TURNED TO FIT ON SITE.

1ST FLOOR HEATED 50 FT. 1533
 2ND FLOOR HEATED 50 FT. 1541
 TOTAL HEATED SQ. FT. 3074

NOTE: IF MATERIAL REQUIRED IF DISTANCE FROM PORCH TO GRADE EXCEEDS 32"

NOTE: FIXED GLASS TO BE PROVIDED BY OWNER

NOTE: ALL FIXED GLASS TO BE REPAIRABLE. REPAIRS TO BE MADE BY OWNER. EXTENSIVE FRAMING FOR FIXED GLASS SHOWN IN PLAN. TURN IN ANY DIRECTION.

APPROVAL DRAWINGS
 NOT FOR CONSTRUCTION

HERITAGE LOG HOMES
 ONE HERITAGE PLACE
 KODAK, TN 37764
 800-456-4663
 APPROVED AS NOTED:
 APPROVED AS NOTED:
 SIGNED:

1ST FLOOR PLAN
 SCALE: 1/8" = 1'-0"

THIS DRAWING MAY NOT BE REPRODUCED OR COMED IN WHOLE OR IN PART WITHOUT EXPRESS WRITTEN PERMISSION OF HERITAGE LOG HOMES INC.

© 2007 HLH INC

LOG #	10414
LOG STYLE	6x12
DRAWING SCALE	AS NOTED
DRAWN BY	D.S.
CHECKED BY	2/1/2007
DATE	
FOUNDATION	BASEMENT
SALES PERSON	JOHN GICK
PLAN NAME	2ND FLOOR PLAN
ROOF TYPE	SQUARE
NAME	HELLAND

HERITAGE LOG HOMES

ONE HERITAGE PLACE KODAK, TN 37664

1-800-456-HOME

WWW.HERITAGELOG.COM

REVISIONS

#	DATE	BY	REVISIONS

APPROVAL


DRAWINGS

NOT FOR CONSTRUCTION

HERITAGE LOG HOMES

ONE HERITAGE PLACE
KODAK, TN 37664
800-456-4663

APPROVED AS NOTED
APPROVED AS IS
SIGNED

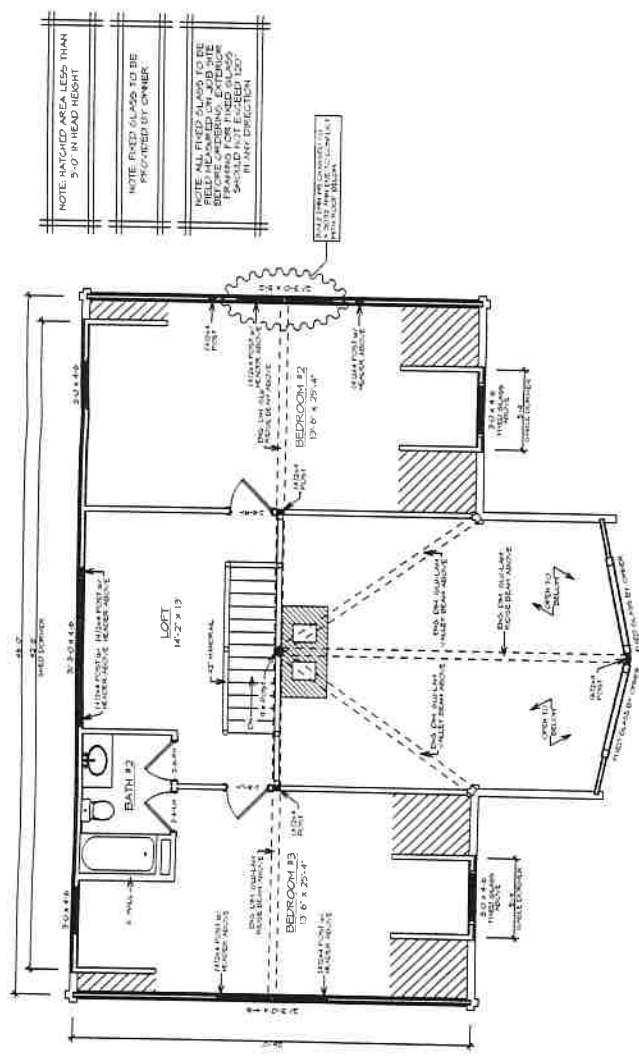

2ND FLOOR PLAN

SCALE: 1/8" = 1'-0"

THIS DRAWING MAY NOT BE REPRODUCED OR COPIED IN WHOLE OR IN PART WITHOUT EXPRESS WRITTEN PERMISSION OF HERITAGE LOG HOMES, INC. © 2007 HLH, INC.	
NAME: HELLAND PLAN NAME: FOUNDATION ROOF TYPE: SQUARE FOUNDATION: BASEMENT SALES PERSON: JOHN GICK	CHECKED BY: [Signature] DATE: 2/1/2007 DRAWN BY: D.S. DRAWING SCALE AS NOTED LOG STYLE: 6x12 JOB #: 10414
REVISIONS:	
DRAWING NUMBER: 6 OF 7	


HERITAGE LOG HOMES
 ONE HERITAGE PLACE KODAK, TN 37764
 1-800-456-HOME
 WWW.HERITAGELOG.COM



APPROVAL
 DRAWINGS
 NOT FOR CONSTRUCTION

HERITAGE LOG HOMES
 ONE HERITAGE PLACE
 KODAK, TN 37764
 800-456-4665
 APPROVED AS NOTED
 DATE: _____
 SIGNED: _____

NOTE: DIMENSIONS SHOWN
 BY HLH. ALL OTHER MATERIAL
 AT THIS LEVEL TO BE SUPPLIED
 BY OWNER

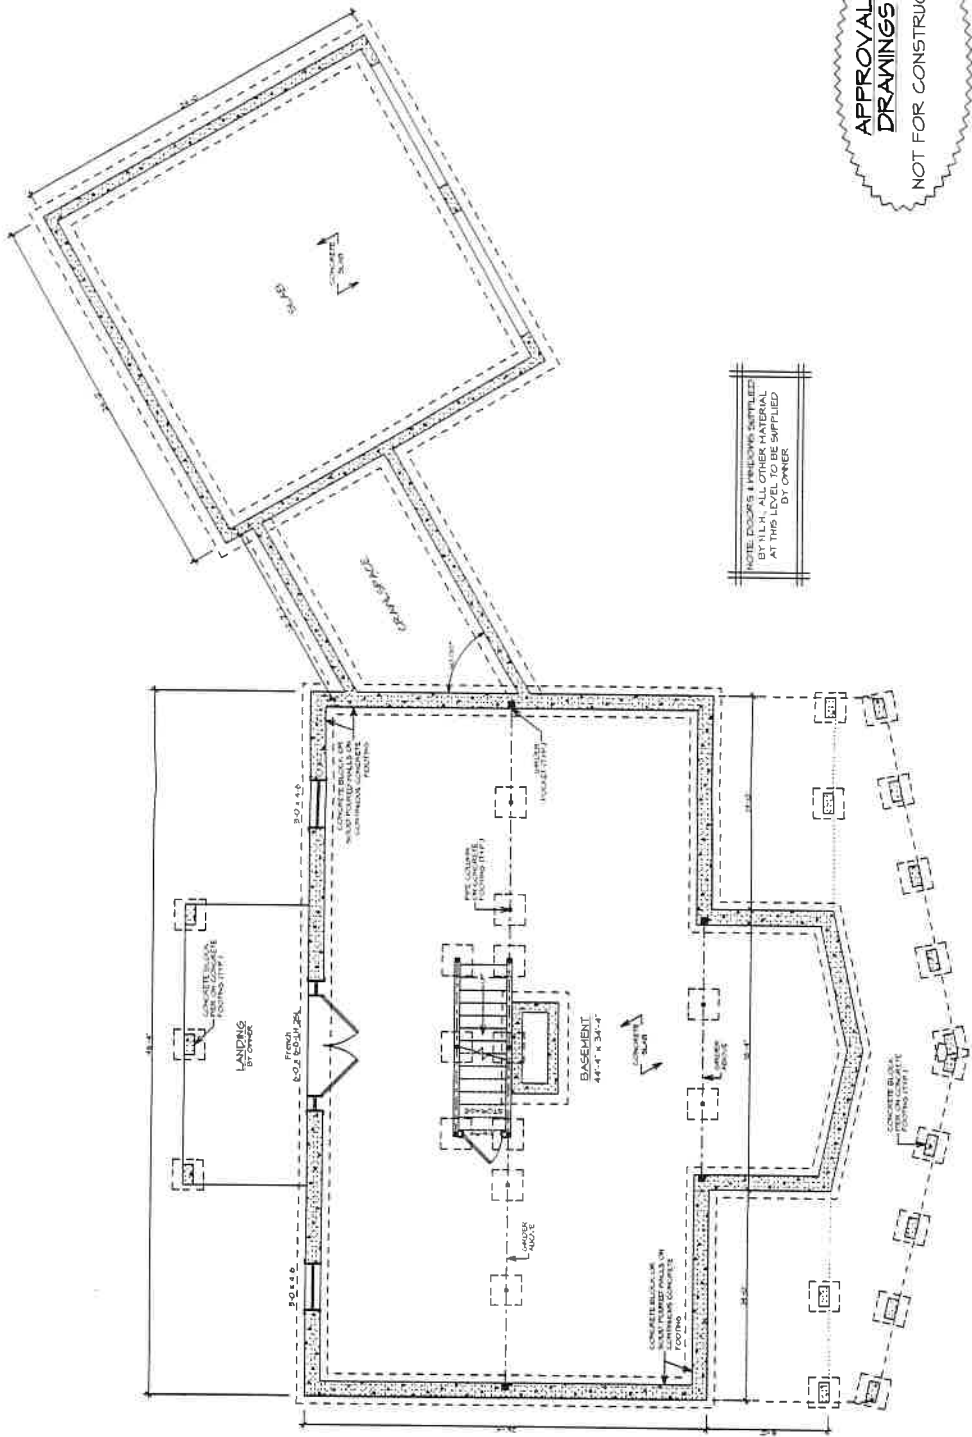

FOUNDATION
 SCALE: 1/8" = 1'-0"